
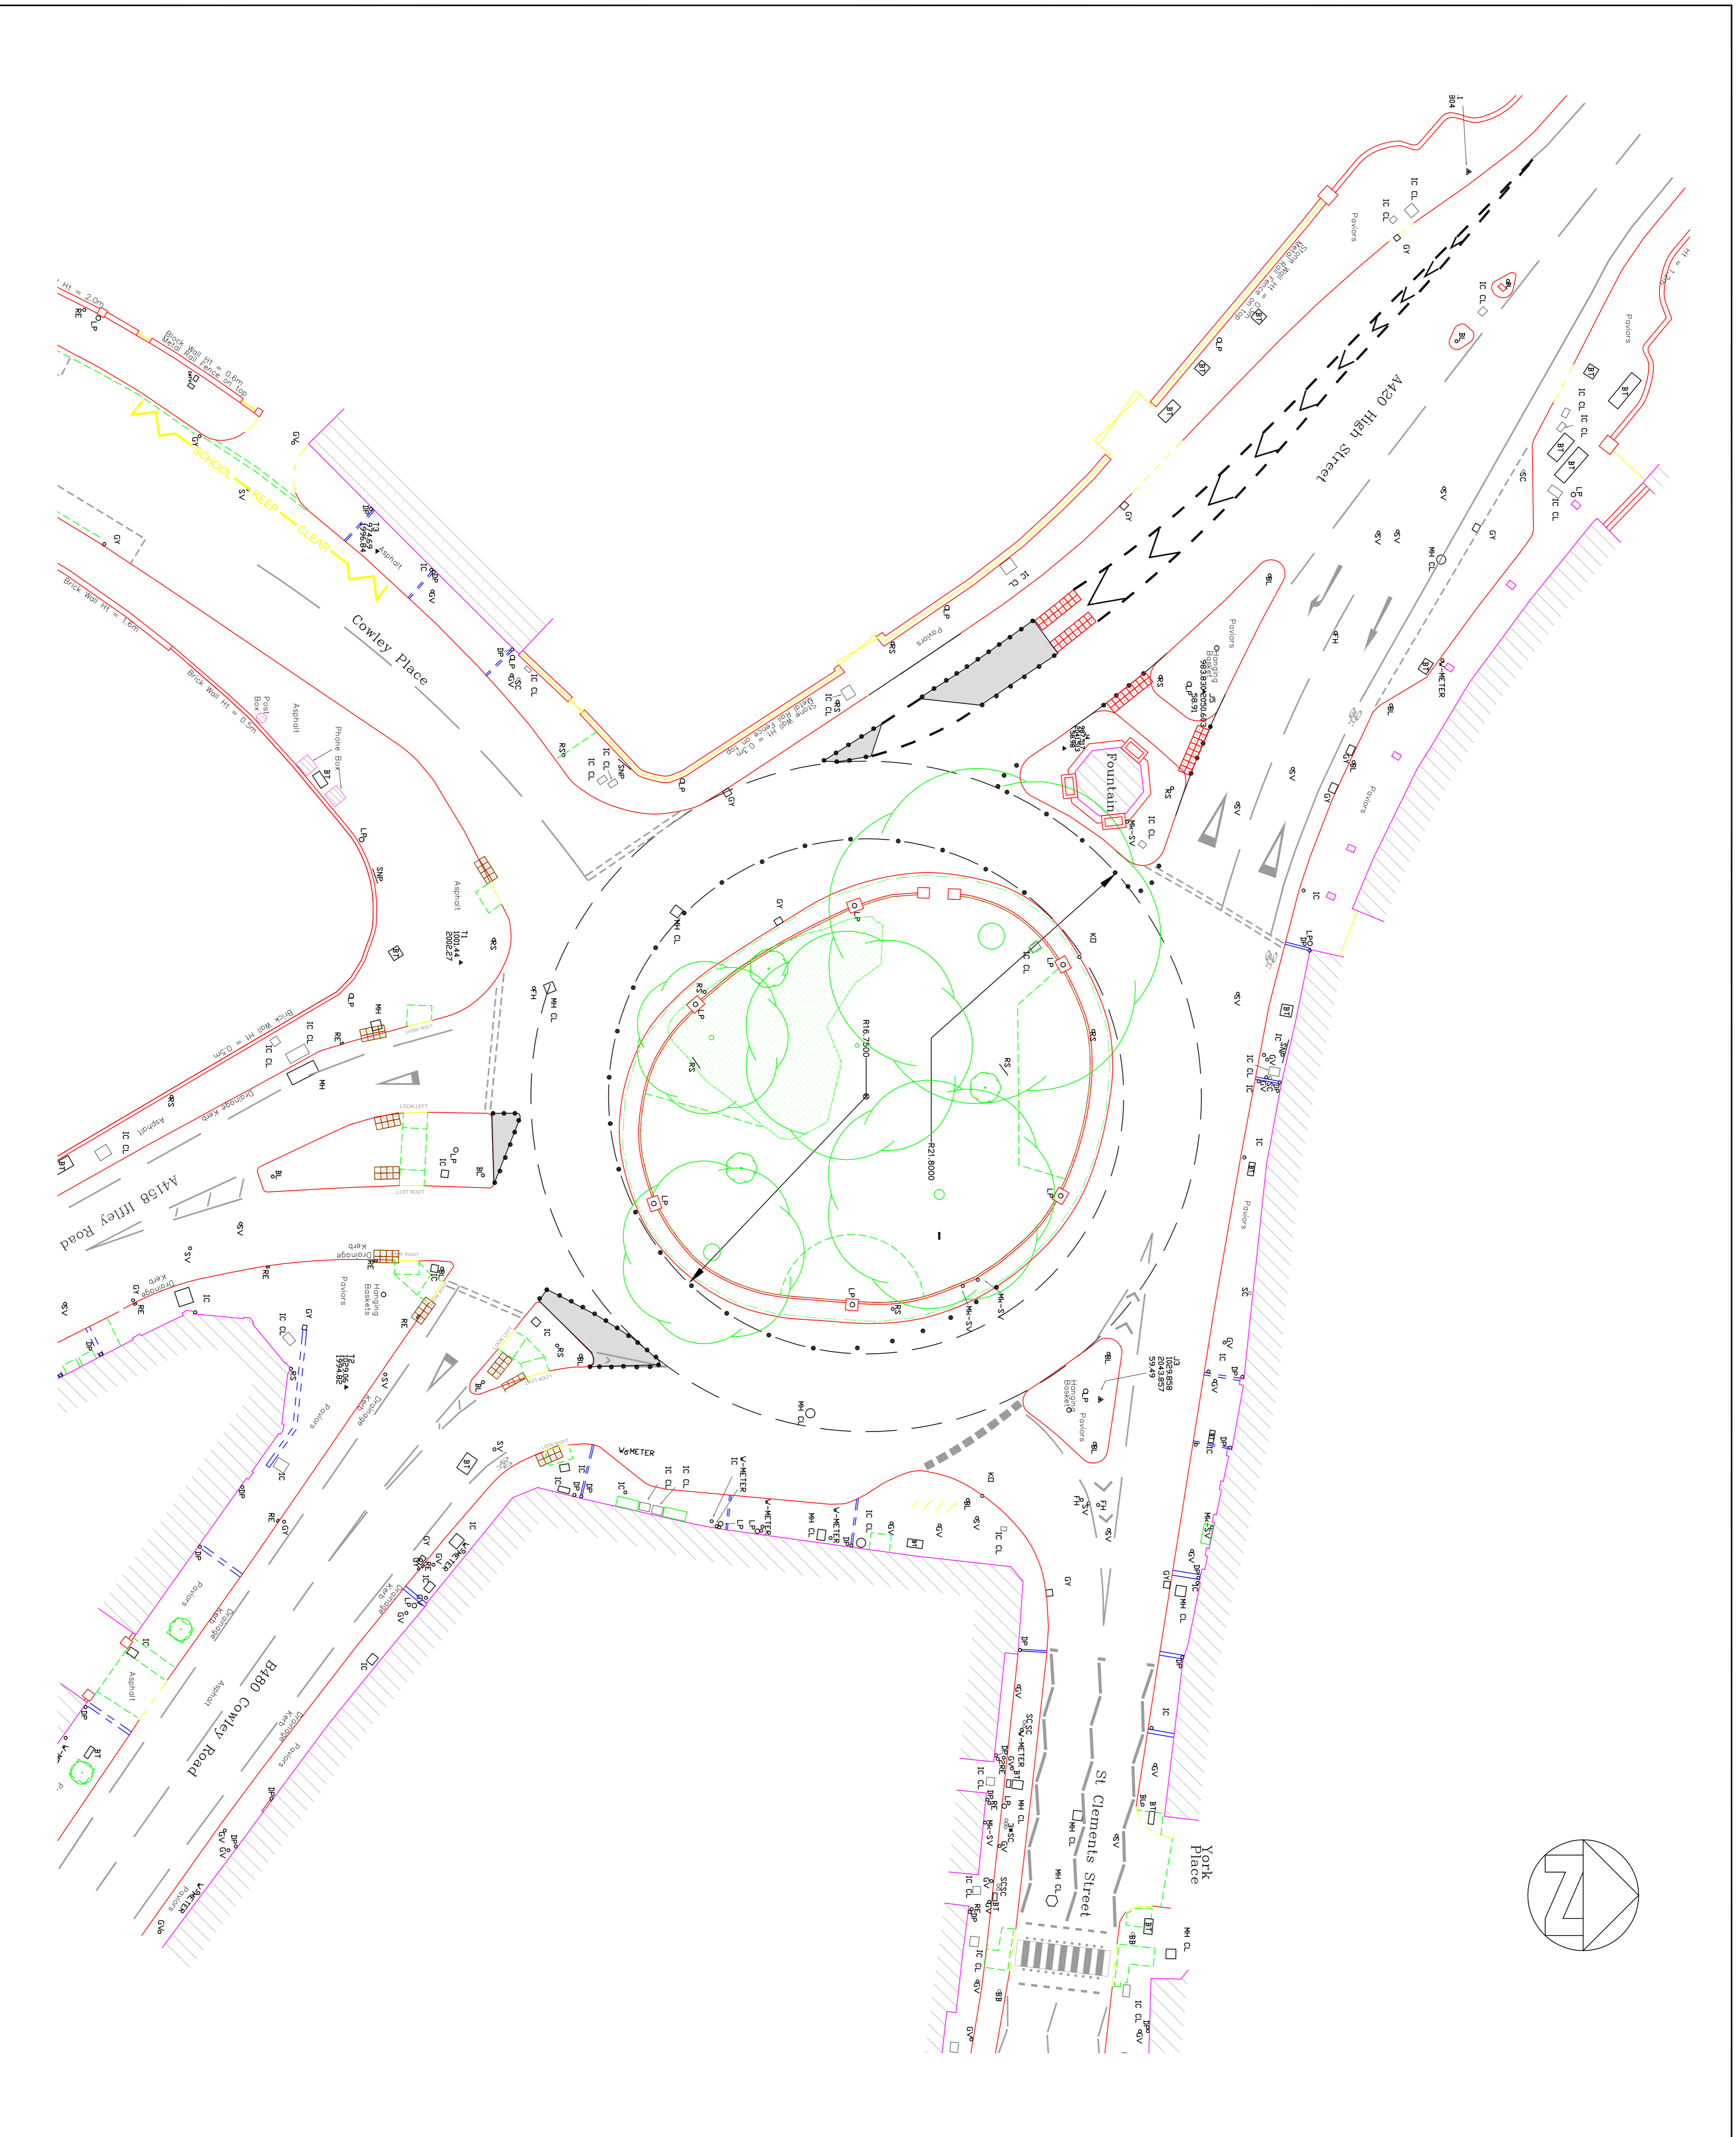


NOTES

- Temporary Kerbs

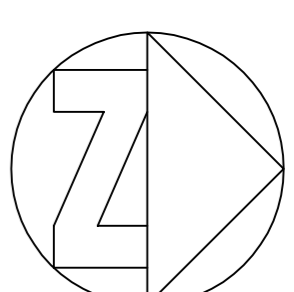

AMENDMENTS	DATE
B Phase 1 As-Built details added, Apr 06	
A Gully and connection added.	Jan 06

The Plain – 8
 A420 High Street
 Proposed Island and
 lining layout

SCALE	INIT/L	DATE
N.T.S.	JD	01/05
	TRACED	01/05
	CHECKED	PBE 12/05

Richard Dudding
 Director for Environment and Economy
 Oxfordshire County Council
 Speedwell House
 Speedwell Street
 Oxford OX1 1NE

DRAWING NUMBER

TP/1/136B

FOR CONSTRUCTION
 (PHASE 2)